


AS BUILT

47 Hanwha 400W modules
1 – SE11400H-USS2 Inverter
1 - SE6000H-USS2 Inverter
18.8 kW DC
17.4 kW AC

Hanwha 400W
Pmax: 400W
Voc: 44.7 V
Isc: 10.9 A

Located underneath each module
SolarEdge S440
Max Output Voltage: 60V
Max Output current: 15A

The Battery will be charged with the PV Array only and will only export power to the Grid for the Connected Solutions Demand Response Program

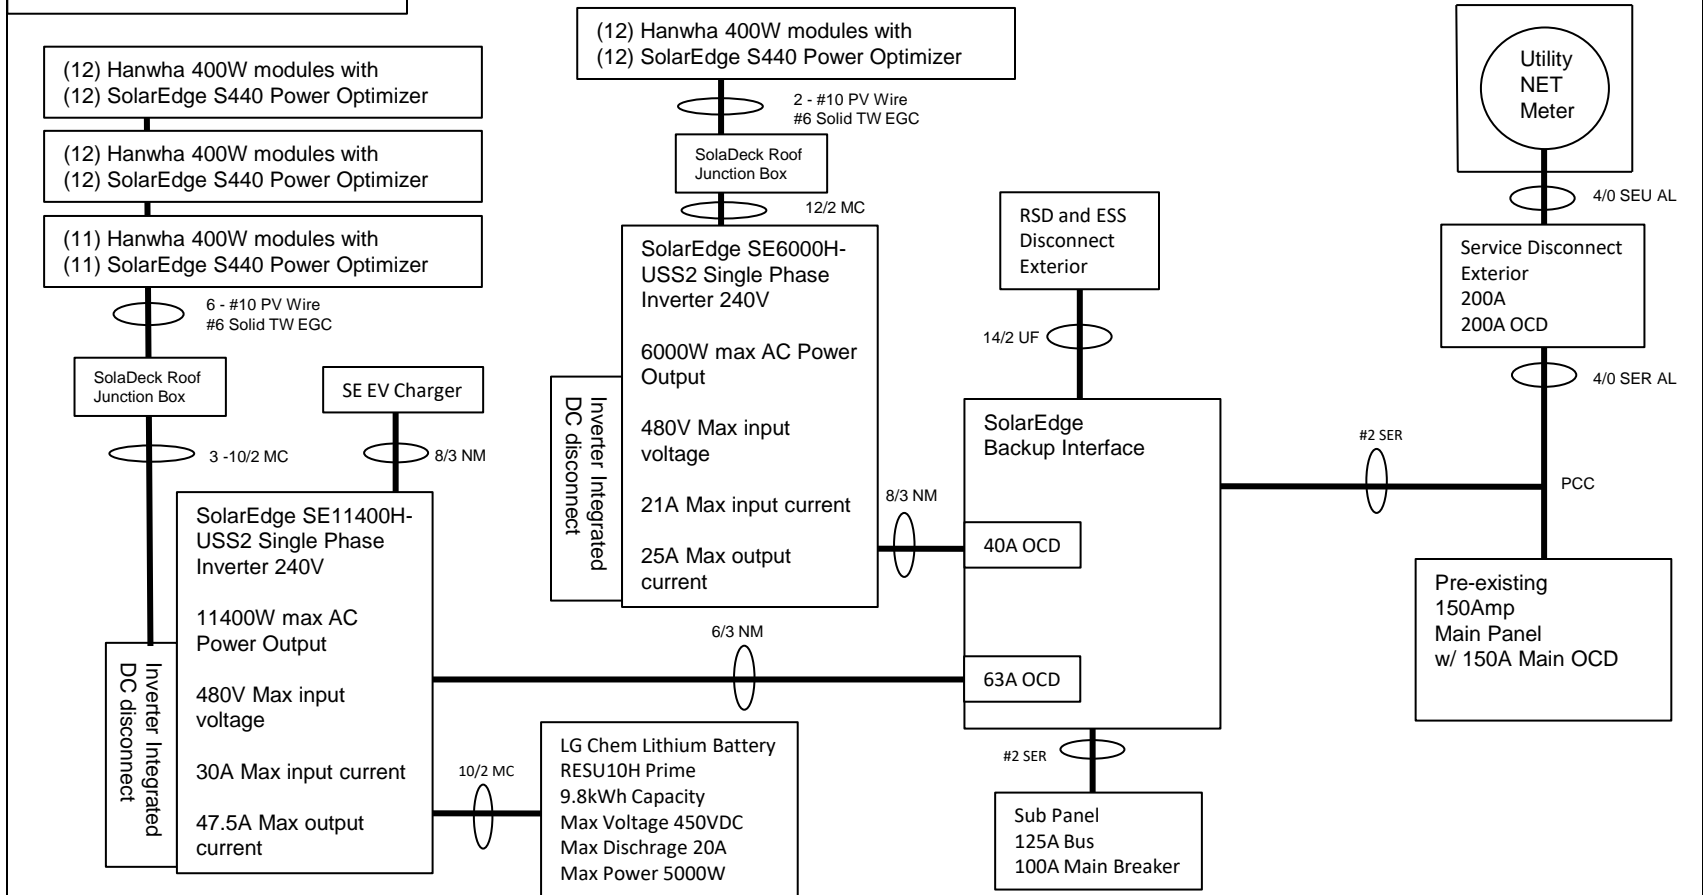

Prepared for: Matthew Ramsey
26 Link Lane
Hope Valley RI 02832

One Line Electrical Diagram
Created By: Tyler Mason
Date: 2/28/23

Sol Power
11 Almy St
Providence, RI. 02909